

SIDES METRES	DIRECTIONS	CO-ORDINATES			S.G. No.
		Y SYSTEM	WG 31	x	
	Constants		0, 00	3200 000, 00	2361/1999 <i>Approved</i> <i>Surveyor-General</i> 1999 10 26
AB	92, C7	287 39 50	A	- 22 611, 33 + 64 993, 15	
BC	4, C8	28 44 30	B	- 22 699, 05 + 65 021, 09	
CD	44, C0	107 39 50	C	- 22 697, 09 + 65 024, 66	
DE	24, 18	17 07 20	D	- 22 655, 17 + 65 011, 31	
EF	19, 19	100 12 40	E	- 22 648, 05 + 65 034, 42	
FA	41, 65	154 46 50	F	- 22 629, 16 + 65 031, 02	
	35/2931	Δ	- 23 377, 39	+ 62 403, 36	PTB 102050
	81/2931	Δ	- 20 162, 81	+ 65 709, 66	

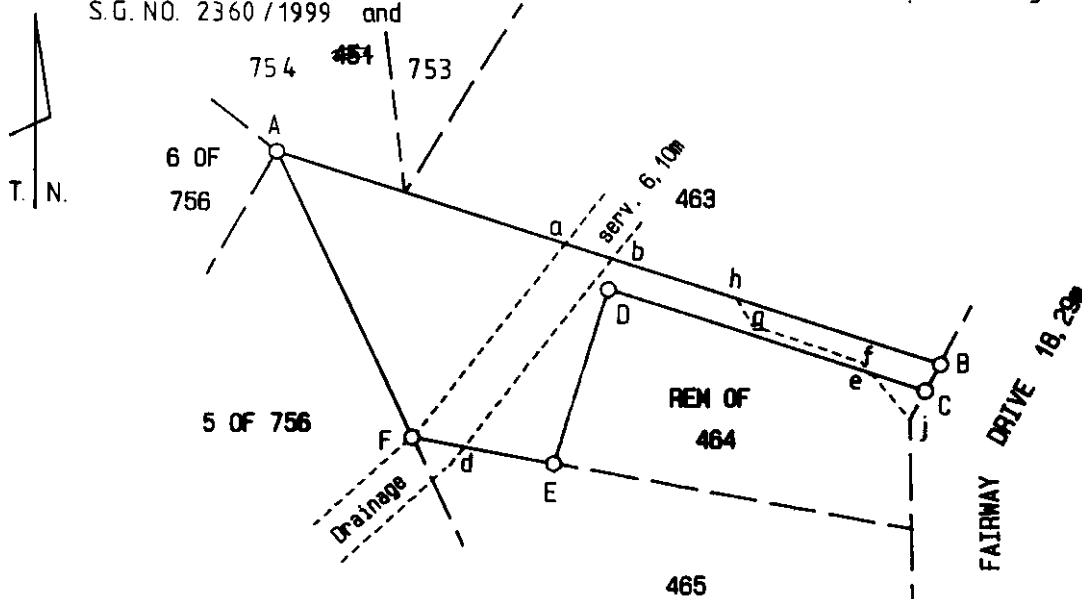
SERVITUDE NOTES:

1. The figure F a b d represents a Drainage Servitude 6,10 metres wide. Vide diagram S.G.No.3395/1983 and Deed of Transfer No.7937/1984.

2. The figure h B C e f g represents a Road Servitude. Vide diagram

S.G.No. 2360/ 1999

3. The figure e C j represents a Road Servitude over the Remainder. Vide diagram S.G. NO. 2360 /1999 and

BEACON DESCRIPTION

A : 12mm Iron pipe
B C D E F : 16mm Iron peg

SCALE 1 : 1000

The figure A B C D E F represents 1171 square metres of land

being

PORTION 1 OF ERF 464 SALT ROCK-FU (~~EXTENSION NO. 1~~)

Situated in the Dolphin Coast T.L.C.
Province of KwaZulu-Natal
Surveyed in November 1993, August 1997
and July 1999
by me, C.J. Boshoff

Professional Land Surveyor
Registration No. PLS 0062

This diagram relates to

The original diagram is

File No. M.F

CRT No.
35008/2004

S.G.No. 3395 /1983

S.R. No. 870/1999

Transfer/~~Grant~~

Comp. FU-5A-5B

No. 7937 /1984

Registrar of Deeds.